

# Work Order ID 92883

Friday, November 09, 2012 3:57:12 PM

**\*92883\***

Page 1

Item ID: D139-799-012 Accept **\*N9000040100\*** Setup Start **\*NS1\***  
 Revision ID: Stop **\*NS2\***  
 Item Name: Maintenance Step  
 Start Date: 11/9/2012 Start Qty: 4.00 **\*4\*** Cust Item ID:  
 Required Date: 11/16/2012 Req'd Qty: 4.00 **\*4\*** Customer:  
 Reference: REWORK PER ECN 12-660

Approvals: Process Plan: MUF Date: 12-11-09 Tooling: Date: Run Start **\*NR1\***  
 QC: Date: SPC (Y/N): Date: Stop **\*NR2\***

| Sequence ID/<br>Work Center ID | Operation<br>Description | Set Up/<br>Run Hours | Tool ID | Tool # | Plan<br>Code | Accept<br>Qty | Reject<br>Qty | Reject<br>Number | Insp.<br>Stamp |
|--------------------------------|--------------------------|----------------------|---------|--------|--------------|---------------|---------------|------------------|----------------|
|--------------------------------|--------------------------|----------------------|---------|--------|--------------|---------------|---------------|------------------|----------------|

|              |              |  |  |  |  |  |  |  |  |
|--------------|--------------|--|--|--|--|--|--|--|--|
| Draw Nbr     | Revision Nbr |  |  |  |  |  |  |  |  |
| IIN-D139-799 | G            |  |  |  |  |  |  |  |  |

150 0.00

**\*150\***

Mill Conv

Conventional Milling Machine

Memo

PULL FROM STOCK D139-799-012 X 4:  
 1 X B 82763  
 3 X B 82143

0.00

12-11-13

4

MUF 12-11-14

REMOVE D4092-042 X 4 AND DISSASSEMBLE TO REWORK PARTS  
 D4093-1/3 PER NEW DRAWING REV D

- SCRAP HARDWARE +

REPLACE WITH NEW

4 sa last page

160

**\*160\***

QC

Quality Control

QC5- Inspect part completeness to step on W/O

0.00

Memo

0.00

12-11-13

NCR: Yes / No

**WORK ORDER NON-CONFORMANCE / UPDATE**

DQA: \_\_\_\_\_ Date: \_\_\_\_\_

QA Closed: \_\_\_\_\_ Date: \_\_\_\_\_

|  |      |      |     |   |                   |   |             |              |              |  |  |
|--|------|------|-----|---|-------------------|---|-------------|--------------|--------------|--|--|
| Work Order: _____<br><br>Part No. _____<br><br>NCR No. _____ |      |      |     | <b>DISPOSITION</b><br><br>Rework <input type="checkbox"/><br>Scrap <input type="checkbox"/><br>Use-as-is <input type="checkbox"/><br>Work Order Update <input type="checkbox"/> |                   | <b>AGAINST DEPARTMENT/PROCESS</b><br><br><div style="display: flex; justify-content: space-between;"> <div>           Skid-tube <input type="checkbox"/><br/>           Machining <input type="checkbox"/><br/>           Thermoforming <input type="checkbox"/><br/>           Large Fab <input type="checkbox"/> </div> <div>           Crosstube <input type="checkbox"/><br/>           Small Fab <input type="checkbox"/><br/>           Finishing <input type="checkbox"/><br/>           Composite <input type="checkbox"/> </div> <div>           Water Jet <input type="checkbox"/><br/>           Prod. Eng. Coord. <input type="checkbox"/><br/>           Rec/Store/Packaging <input type="checkbox"/><br/>           Supplier <input type="checkbox"/> </div> <div>           Engineering <input type="checkbox"/><br/>           Quality <input type="checkbox"/><br/>           Other <input type="checkbox"/> </div> </div> |             |              |              |  |  |
| Root Cause   | Date | Step | Qty | Description of work order update or Non-conformance   | Initial Chief Eng | Action Description  | Sign & Date | Verification | QC Inspector |  |  |
| Doc/Data <input type="checkbox"/>                            |      |      |     |   |                   |   |             |              |              |  |  |
| Equip/Tooling <input type="checkbox"/>                       |      |      |     |   |                   |   |             |              |              |  |  |
| Operator <input type="checkbox"/>                            |      |      |     |   |                   |   |             |              |              |  |  |
| Material <input type="checkbox"/>                            |      |      |     |   |                   |   |             |              |              |  |  |
| Setup <input type="checkbox"/>                               |      |      |     |   |                   |   |             |              |              |  |  |
| Other <input type="checkbox"/>                               |      |      |     |   |                   |   |             |              |              |  |  |
| Process <input type="checkbox"/>                             |      |      |     |   |                   |   |             |              |              |  |  |
| Supplier <input type="checkbox"/>                            |      |      |     |   |                   |   |             |              |              |  |  |
| Training <input type="checkbox"/>                            |      |      |     |   |                   |   |             |              |              |  |  |
| Unapproved <input type="checkbox"/>                          |      |      |     |   |                   |   |             |              |              |  |  |

| FAULT CATEGORY   |   |   |  |   |
|--|---|---|--|---|
| <b>Landing Gear</b><br><input type="checkbox"/> Bending<br><input type="checkbox"/> Centre Not Concentric to O/S<br><input type="checkbox"/> Cracks<br><input type="checkbox"/> Crushed/Crimped.<br><input type="checkbox"/> Cuffs<br><input type="checkbox"/> Heat Treat<br><input type="checkbox"/> Inspection Strip in Tube<br><input type="checkbox"/> Ripples in Bend<br><input type="checkbox"/> Torque Waves in Extrusion<br><input type="checkbox"/> Turning Sequence<br><input type="checkbox"/> Wave/Twist in Tube | <b>General</b><br><input type="checkbox"/> Bend<br><input type="checkbox"/> BOM/Route<br><input type="checkbox"/> Broken/Damaged<br><input type="checkbox"/> Burrs<br><input type="checkbox"/> Contamination<br><input type="checkbox"/> Countersink<br><input type="checkbox"/> Cut Too Short<br><input type="checkbox"/> Drill Holes<br><input type="checkbox"/> Drawing<br><input type="checkbox"/> Finish<br><input type="checkbox"/> Folio | <input type="checkbox"/> Grain<br><input type="checkbox"/> Hardware<br><input type="checkbox"/> Inspection Incomplete<br><input type="checkbox"/> Instructions Incomplete/Unclear<br><input type="checkbox"/> Maintenance<br><input type="checkbox"/> Mislabeled<br><input type="checkbox"/> Misread<br><input type="checkbox"/> Offset<br><input type="checkbox"/> Out of Calibration<br><input type="checkbox"/> Out of Sequence<br><input type="checkbox"/> Outside Dimensions | <input type="checkbox"/> Ovalized<br><input type="checkbox"/> Over/Under tolerance<br><input type="checkbox"/> Part Incorrect<br><input type="checkbox"/> Part Lost/Missing<br><input type="checkbox"/> Part Moved<br><input type="checkbox"/> Positioned Wrong<br><input type="checkbox"/> Power Loss/Surge | <input type="checkbox"/> Pressure/Forced<br><input type="checkbox"/> Temperature/Cure<br><input type="checkbox"/> Weld<br><input type="checkbox"/> Wrong Stock Pulled<br><input type="checkbox"/> Other |

**Work Order ID 92883**

Friday, November 09, 2012 3:57:12 PM

**\*92883\***

Page 2

Item ID: D139-799-012

Accept

**\*N900040100\***Setup Start **\*NS1\***

Revision ID:

Item Name: Maintenance Step

Stop **\*NS2\***

Start Date: 11/9/2012 Start Qty: 4.00

**\*4\***

Cust Item ID:

Required Date: 11/16/2012 Req'd Qty: 4.00

**\*4\***

Customer:

Reference: REWORK PER ECN 12-660

Approvals: Process Plan:

Date:

Tooling:

Date:

Run Start **\*NR1\***

QC:

Date:

SPC (Y/N):

Date:

Stop **\*NR2\***Sequence ID/  
Work Center IDOperation  
DescriptionSet Up/  
Run Hours

Tool ID

Tool #

Plan  
CodeAccept  
QtyReject  
QtyReject  
NumberInsp.  
Stamp

170

Chemical Conversion Coat per QSI005 4.1

0.00

**\*170\***

HandFinish

Memo

0.00

Hand Finishing

TOUCH UP WITH ALODINE d4093-1 &amp;-3 ON REWORKED AREA

4 NG 12-11-13

180

QC7-Inspect Chemical Conversion Coat

0.00

**\*180\***

QC

Memo

0.00

Quality Control

4X

190

0.00

**\*190\***

Small Fab

Memo

0.00

Small Fab

RE-ASSEMBLE KIT

4X

NCR: Yes / No

**WORK ORDER NON-CONFORMANCE / UPDATE**

DQA: \_\_\_\_\_ Date: \_\_\_\_\_

QA Closed: \_\_\_\_\_ Date: \_\_\_\_\_

|  |   |   |                                      |                                    |                                    |                                      |                                    |                                    |  |                                  |  |                                    |  |                                |                                    |                                    |                                   |  |
|--|---|---|--------------------------------------|------------------------------------|------------------------------------|--------------------------------------|------------------------------------|------------------------------------|--|----------------------------------|--|------------------------------------|--|--------------------------------|------------------------------------|------------------------------------|-----------------------------------|--|
| Work Order: _____<br><br>Part No. _____<br><br>NCR No. _____ | <b>DISPOSITION</b><br><br>Rework <input type="checkbox"/><br>Scrap <input type="checkbox"/><br>Use-as-is <input type="checkbox"/><br>Work Order Update <input type="checkbox"/> | <b>AGAINST DEPARTMENT/PROCESS</b><br><br><table style="width: 100%;"> <tr> <td>Skid-tube <input type="checkbox"/></td> <td>Crosstube <input type="checkbox"/></td> <td>Water Jet <input type="checkbox"/></td> <td>Engineering <input type="checkbox"/></td> </tr> <tr> <td>Machining <input type="checkbox"/></td> <td>Small Fab <input type="checkbox"/></td> <td>Prod. Eng. Coord. <input type="checkbox"/></td> <td>Quality <input type="checkbox"/></td> </tr> <tr> <td>Thermoforming <input type="checkbox"/></td> <td>Finishing <input type="checkbox"/></td> <td>Rec/Store/Packaging <input type="checkbox"/></td> <td>Other <input type="checkbox"/></td> </tr> <tr> <td>Large Fab <input type="checkbox"/></td> <td>Composite <input type="checkbox"/></td> <td>Supplier <input type="checkbox"/></td> <td></td> </tr> </table> | Skid-tube <input type="checkbox"/>   | Crosstube <input type="checkbox"/> | Water Jet <input type="checkbox"/> | Engineering <input type="checkbox"/> | Machining <input type="checkbox"/> | Small Fab <input type="checkbox"/> | Prod. Eng. Coord. <input type="checkbox"/> | Quality <input type="checkbox"/> | Thermoforming <input type="checkbox"/> | Finishing <input type="checkbox"/> | Rec/Store/Packaging <input type="checkbox"/> | Other <input type="checkbox"/> | Large Fab <input type="checkbox"/> | Composite <input type="checkbox"/> | Supplier <input type="checkbox"/> |  |
| Skid-tube <input type="checkbox"/>                           | Crosstube <input type="checkbox"/>  | Water Jet <input type="checkbox"/>  | Engineering <input type="checkbox"/> |                                    |                                    |                                      |                                    |                                    |  |                                  |  |                                    |  |                                |                                    |                                    |                                   |  |
| Machining <input type="checkbox"/>                           | Small Fab <input type="checkbox"/>  | Prod. Eng. Coord. <input type="checkbox"/>  | Quality <input type="checkbox"/>     |                                    |                                    |                                      |                                    |                                    |  |                                  |  |                                    |  |                                |                                    |                                    |                                   |  |
| Thermoforming <input type="checkbox"/>                       | Finishing <input type="checkbox"/>  | Rec/Store/Packaging <input type="checkbox"/>  | Other <input type="checkbox"/>       |                                    |                                    |                                      |                                    |                                    |  |                                  |  |                                    |  |                                |                                    |                                    |                                   |  |
| Large Fab <input type="checkbox"/>                           | Composite <input type="checkbox"/>  | Supplier <input type="checkbox"/>   |                                      |                                    |                                    |                                      |                                    |                                    |  |                                  |  |                                    |  |                                |                                    |                                    |                                   |  |

| Root Cause    | Date | Step | Qty | Description of work order update or Non-conformance | Initial Chief Eng | Action Description | Sign & Date | Verification | QC Inspector |
|---------------|------|------|-----|---|-------------------|--------------------|-------------|--------------|--------------|
| Doc/Data      |      |      |     |   |                   |                    |             |              |              |
| Equip/Tooling |      |      |     |   |                   |                    |             |              |              |
| Operator      |      |      |     |   |                   |                    |             |              |              |
| Material      |      |      |     |   |                   |                    |             |              |              |
| Setup         |      |      |     |   |                   |                    |             |              |              |
| Other         |      |      |     |   |                   |                    |             |              |              |
| Process       |      |      |     |   |                   |                    |             |              |              |
| Supplier      |      |      |     |   |                   |                    |             |              |              |
| Training      |      |      |     |   |                   |                    |             |              |              |
| Unapproved    |      |      |     |   |                   |                    |             |              |              |

**FAULT CATEGORY**

|  |   |   |
|--|---|---|
| <b>Landing Gear</b><br><input type="checkbox"/> Bending<br><input type="checkbox"/> Centre Not Concentric to O/S<br><input type="checkbox"/> Cracks<br><input type="checkbox"/> Crushed/Crimped.<br><input type="checkbox"/> Cuffs<br><input type="checkbox"/> Heat Treat<br><input type="checkbox"/> Inspection Strip in Tube<br><input type="checkbox"/> Ripples in Bend<br><input type="checkbox"/> Torque Waves in Extrusion<br><input type="checkbox"/> Turning Sequence<br><input type="checkbox"/> Wave/Twist in Tube | <b>General</b><br><input type="checkbox"/> Bend<br><input type="checkbox"/> BOM/Route<br><input type="checkbox"/> Broken/Damaged<br><input type="checkbox"/> Burrs<br><input type="checkbox"/> Contamination<br><input type="checkbox"/> Countersink<br><input type="checkbox"/> Cut Too Short<br><input type="checkbox"/> Drill Holes<br><input type="checkbox"/> Drawing<br><input type="checkbox"/> Finish<br><input type="checkbox"/> Folio | <input type="checkbox"/> Grain<br><input type="checkbox"/> Hardware<br><input type="checkbox"/> Inspection Incomplete<br><input type="checkbox"/> Instructions Incomplete/Unclear<br><input type="checkbox"/> Maintenance<br><input type="checkbox"/> Mislabeled<br><input type="checkbox"/> Misread<br><input type="checkbox"/> Offset<br><input type="checkbox"/> Out of Calibration<br><input type="checkbox"/> Out of Sequence<br><input type="checkbox"/> Outside Dimensions |
| <input type="checkbox"/> Ovalized<br><input type="checkbox"/> Over/Under tolerance<br><input type="checkbox"/> Part Incorrect<br><input type="checkbox"/> Part Lost/Missing<br><input type="checkbox"/> Part Moved<br><input type="checkbox"/> Positioned Wrong<br><input type="checkbox"/> Power Loss/Surge   |   |   |
| <input type="checkbox"/> Pressure/Forced<br><input type="checkbox"/> Temperature/Cure<br><input type="checkbox"/> Weld<br><input type="checkbox"/> Wrong Stock Pulled<br><input type="checkbox"/> Other  |   |   |

# Work Order ID 92883

Friday, November 09, 2012 3:57:12 PM

**\*92883\***

Page 3

Item ID: D139-799-012

Accept

**\*N900040100\***

Setup Start **\*NS1\***

Revision ID:

Item Name: Maintenance Step

Stop **\*NS2\***

Start Date: 11/9/2012 Start Qty: 4.00

**\*4\***

Cust Item ID:

Required Date: 11/16/2012 Req'd Qty: 4.00

**\*4\***

Customer:

Reference: REWORK PER ECN 12-660

Approvals: Process Plan:

Date:

Tooling:

Date:

Run Start **\*NR1\***

QC:

Date:

SPC (Y/N):

Date:

Stop **\*NR2\***

Sequence ID/  
Work Center ID

Operation  
Description

Set Up/  
Run Hours

Tool ID

Tool #

Plan  
Code

Accept  
Qty

Reject  
Qty

Reject  
Number

Insp.  
Stamp

200

QC5- Inspect part completeness to step on W/O

0.00

**\*200\***

QC

Memo

0.00

Quality Control

210

Pick Kit

0.00

**\*210\***

Packaging

Memo

0.00

Packaging

REMOVE FROM KIT AN6H12 X 16 B AND RETURN TO STOCK M121340 16

REPLACE WITH:

AN6H12A X 2 PER KIT B M123560

AN6H13A X 2 PER KIT B M123560

PER ECN 12-660

ID AND STOCK UNDER NEW BATCH NUMBER AT CHANGE 004

NCR: Yes / No

## WORK ORDER NON-CONFORMANCE / UPDATE

DQA: \_\_\_\_\_ Date: \_\_\_\_\_

QA Closed: \_\_\_\_\_ Date: \_\_\_\_\_

|  |      |      |     |   |                   |   |             |              |              |  |  |
|--|------|------|-----|---|-------------------|---|-------------|--------------|--------------|--|--|
| Work Order: _____<br><br>Part No. _____<br><br>NCR No. _____ |      |      |     | <b>DISPOSITION</b><br><br>Rework <input type="checkbox"/><br>Scrap <input type="checkbox"/><br>Use-as-is <input type="checkbox"/><br>Work Order Update <input type="checkbox"/> |                   | <b>AGAINST DEPARTMENT/PROCESS</b><br><br><div style="display: flex; justify-content: space-between;"> <div>           Skid-tube <input type="checkbox"/><br/>           Machining <input type="checkbox"/><br/>           Thermoforming <input type="checkbox"/><br/>           Large Fab <input type="checkbox"/> </div> <div>           Crosstube <input type="checkbox"/><br/>           Small Fab <input type="checkbox"/><br/>           Finishing <input type="checkbox"/><br/>           Composite <input type="checkbox"/> </div> <div>           Water Jet <input type="checkbox"/><br/>           Prod. Eng. Coord. <input type="checkbox"/><br/>           Rec/Store/Packaging <input type="checkbox"/><br/>           Supplier <input type="checkbox"/> </div> <div>           Engineering <input type="checkbox"/><br/>           Quality <input type="checkbox"/><br/>           Other <input type="checkbox"/> </div> </div> |             |              |              |  |  |
| <b>Root Cause</b>  | Date | Step | Qty | Description of work order update or Non-conformance   | Initial Chief Eng | Action Description  | Sign & Date | Verification | QC Inspector |  |  |
| Doc/Data   |      |      |     |   |                   |   |             |              |              |  |  |
| Equip/Tooling  |      |      |     |   |                   |   |             |              |              |  |  |
| Operator   |      |      |     |   |                   |   |             |              |              |  |  |
| Material   |      |      |     |   |                   |   |             |              |              |  |  |
| Setup  |      |      |     |   |                   |   |             |              |              |  |  |
| Other  |      |      |     |   |                   |   |             |              |              |  |  |
| Process  |      |      |     |   |                   |   |             |              |              |  |  |
| Supplier   |      |      |     |   |                   |   |             |              |              |  |  |
| Training   |      |      |     |   |                   |   |             |              |              |  |  |
| Unapproved   |      |      |     |   |                   |   |             |              |              |  |  |

| FAULT CATEGORY  |  |  |   |  |  |   |  |  |  |  |   |
|---|--|--|---|--|--|---|--|--|--|--|---|
| <b>Landing Gear</b><br><input type="checkbox"/> Bending<br><input type="checkbox"/> Centre Not Concentric to O/S<br><input type="checkbox"/> Cracks<br><input type="checkbox"/> Crushed/Crimped<br><input type="checkbox"/> Cuffs<br><input type="checkbox"/> Heat Treat<br><input type="checkbox"/> Inspection Strip in Tube<br><input type="checkbox"/> Ripples in Bend<br><input type="checkbox"/> Torque Waves in Extrusion<br><input type="checkbox"/> Turning Sequence<br><input type="checkbox"/> Wave/Twist in Tube |  |  | <b>General</b><br><input type="checkbox"/> Bend<br><input type="checkbox"/> BOM/Route<br><input type="checkbox"/> Broken/Damaged<br><input type="checkbox"/> Burrs<br><input type="checkbox"/> Contamination<br><input type="checkbox"/> Countersink<br><input type="checkbox"/> Cut Too Short<br><input type="checkbox"/> Drill Holes<br><input type="checkbox"/> Drawing<br><input type="checkbox"/> Finish<br><input type="checkbox"/> Folio |  |  | <input type="checkbox"/> Grain<br><input type="checkbox"/> Hardware<br><input type="checkbox"/> Inspection Incomplete<br><input type="checkbox"/> Instructions Incomplete/Unclear<br><input type="checkbox"/> Maintenance<br><input type="checkbox"/> Mislabeled<br><input type="checkbox"/> Misread<br><input type="checkbox"/> Offset<br><input type="checkbox"/> Out of Calibration<br><input type="checkbox"/> Out of Sequence<br><input type="checkbox"/> Outside Dimensions |  |  | <input type="checkbox"/> Ovalized<br><input type="checkbox"/> Over/Under tolerance<br><input type="checkbox"/> Part Incorrect<br><input type="checkbox"/> Part Lost/Missing<br><input type="checkbox"/> Part Moved<br><input type="checkbox"/> Positioned Wrong<br><input type="checkbox"/> Power Loss/Surge |  | <input type="checkbox"/> Pressure/Forced<br><input type="checkbox"/> Temperature/Cure<br><input type="checkbox"/> Weld<br><input type="checkbox"/> Wrong Stock Pulled<br><br><input type="checkbox"/> Other |

# Work Order ID 92883

\*92883\*

Page 4

Friday, November 09, 2012 3:57:12 PM

Item ID: D139-799-012

Accept

\*N900040100\*

Setup Start \*NS1\*

Revision ID:

Stop \*NS2\*

Item Name: Maintenance Step

Start Date: 11/9/2012 Start Qty: 4.00

\*4\*

Cust Item ID:

Required Date: 11/16/2012 Req'd Qty: 4.00

\*4\*

Customer:

Reference: REWORK PER ECN 12-660

Approvals:

Process Plan:

Date:

Tooling:

Date:

Run Start \*NR1\*

QC:

Date:

SPC (Y/N):

Date:

Stop \*NR2\*

Sequence ID/  
Work Center ID

Operation  
Description

Set Up/  
Run Hours

Tool ID

Tool #

Plan  
Code

Accept  
Qty

Reject  
Qty

Reject  
Number

Insp.  
Stamp

220

QC4- 100% Inspect kits for completeness

0.00

\*220\*

QC

Memo

0.00

Quality Control

230

QC21- Final Inspection - Work Order Release

0.00

\*230\*

QC

Memo

0.00

Quality Control

DAS  
15  
2.89

121114

Reob

Loc23

4

40

121114sf

MLJ 12-11-14

MF  
12-11-14

NCR: Yes / No

**WORK ORDER NON-CONFORMANCE / UPDATE**

DQA: \_\_\_\_\_ Date: \_\_\_\_\_

QA Closed: \_\_\_\_\_ Date: \_\_\_\_\_

|  |   |   |                                      |                                    |                                    |                                      |                                    |                                    |  |                                  |  |                                    |  |                                |                                    |                                    |                                   |  |
|--|---|---|--------------------------------------|------------------------------------|------------------------------------|--------------------------------------|------------------------------------|------------------------------------|--|----------------------------------|--|------------------------------------|--|--------------------------------|------------------------------------|------------------------------------|-----------------------------------|--|
| Work Order: _____<br><br>Part No. _____<br><br>NCR No. _____ | <b>DISPOSITION</b><br><br>Rework <input type="checkbox"/><br>Scrap <input type="checkbox"/><br>Use-as-is <input type="checkbox"/><br>Work Order Update <input type="checkbox"/> | <b>AGAINST DEPARTMENT/PROCESS</b><br><br><table style="width: 100%;"> <tr> <td>Skid-tube <input type="checkbox"/></td> <td>Crosstube <input type="checkbox"/></td> <td>Water Jet <input type="checkbox"/></td> <td>Engineering <input type="checkbox"/></td> </tr> <tr> <td>Machining <input type="checkbox"/></td> <td>Small Fab <input type="checkbox"/></td> <td>Prod. Eng. Coord. <input type="checkbox"/></td> <td>Quality <input type="checkbox"/></td> </tr> <tr> <td>Thermoforming <input type="checkbox"/></td> <td>Finishing <input type="checkbox"/></td> <td>Rec/Store/Packaging <input type="checkbox"/></td> <td>Other <input type="checkbox"/></td> </tr> <tr> <td>Large Fab <input type="checkbox"/></td> <td>Composite <input type="checkbox"/></td> <td>Supplier <input type="checkbox"/></td> <td></td> </tr> </table> | Skid-tube <input type="checkbox"/>   | Crosstube <input type="checkbox"/> | Water Jet <input type="checkbox"/> | Engineering <input type="checkbox"/> | Machining <input type="checkbox"/> | Small Fab <input type="checkbox"/> | Prod. Eng. Coord. <input type="checkbox"/> | Quality <input type="checkbox"/> | Thermoforming <input type="checkbox"/> | Finishing <input type="checkbox"/> | Rec/Store/Packaging <input type="checkbox"/> | Other <input type="checkbox"/> | Large Fab <input type="checkbox"/> | Composite <input type="checkbox"/> | Supplier <input type="checkbox"/> |  |
| Skid-tube <input type="checkbox"/>                           | Crosstube <input type="checkbox"/>  | Water Jet <input type="checkbox"/>  | Engineering <input type="checkbox"/> |                                    |                                    |                                      |                                    |                                    |  |                                  |  |                                    |  |                                |                                    |                                    |                                   |  |
| Machining <input type="checkbox"/>                           | Small Fab <input type="checkbox"/>  | Prod. Eng. Coord. <input type="checkbox"/>  | Quality <input type="checkbox"/>     |                                    |                                    |                                      |                                    |                                    |  |                                  |  |                                    |  |                                |                                    |                                    |                                   |  |
| Thermoforming <input type="checkbox"/>                       | Finishing <input type="checkbox"/>  | Rec/Store/Packaging <input type="checkbox"/>  | Other <input type="checkbox"/>       |                                    |                                    |                                      |                                    |                                    |  |                                  |  |                                    |  |                                |                                    |                                    |                                   |  |
| Large Fab <input type="checkbox"/>                           | Composite <input type="checkbox"/>  | Supplier <input type="checkbox"/>   |                                      |                                    |                                    |                                      |                                    |                                    |  |                                  |  |                                    |  |                                |                                    |                                    |                                   |  |

| Root Cause    | Date | Step | Qty | Description of work order update or Non-conformance | Initial Chief Eng | Action Description | Sign & Date | Verification | QC Inspector |
|---------------|------|------|-----|---|-------------------|--------------------|-------------|--------------|--------------|
| Doc/Data      |      |      |     |   |                   |                    |             |              |              |
| Equip/Tooling |      |      |     |   |                   |                    |             |              |              |
| Operator      |      |      |     |   |                   |                    |             |              |              |
| Material      |      |      |     |   |                   |                    |             |              |              |
| Setup         |      |      |     |   |                   |                    |             |              |              |
| Other         |      |      |     |   |                   |                    |             |              |              |
| Process       |      |      |     |   |                   |                    |             |              |              |
| Supplier      |      |      |     |   |                   |                    |             |              |              |
| Training      |      |      |     |   |                   |                    |             |              |              |
| Unapproved    |      |      |     |   |                   |                    |             |              |              |

**FAULT CATEGORY**

| Landing Gear  | General                                 | Other  |
|---|---|--|
| <input type="checkbox"/> Bending                      | <input type="checkbox"/> Bend           | <input type="checkbox"/> Grain                           |
| <input type="checkbox"/> Centre Not Concentric to O/S | <input type="checkbox"/> BOM/Route      | <input type="checkbox"/> Hardware                        |
| <input type="checkbox"/> Cracks                       | <input type="checkbox"/> Broken/Damaged | <input type="checkbox"/> Inspection Incomplete           |
| <input type="checkbox"/> Crushed/Crimped              | <input type="checkbox"/> Burrs          | <input type="checkbox"/> Instructions Incomplete/Unclear |
| <input type="checkbox"/> Cuffs                        | <input type="checkbox"/> Contamination  | <input type="checkbox"/> Maintenance                     |
| <input type="checkbox"/> Heat Treat                   | <input type="checkbox"/> Countersink    | <input type="checkbox"/> Mislabeled                      |
| <input type="checkbox"/> Inspection Strip in Tube     | <input type="checkbox"/> Cut Too Short  | <input type="checkbox"/> Misread                         |
| <input type="checkbox"/> Ripples in Bend              | <input type="checkbox"/> Drill Holes    | <input type="checkbox"/> Offset                          |
| <input type="checkbox"/> Torque Waves in Extrusion    | <input type="checkbox"/> Drawing        | <input type="checkbox"/> Out of Calibration              |
| <input type="checkbox"/> Turning Sequence             | <input type="checkbox"/> Finish         | <input type="checkbox"/> Out of Sequence                 |
| <input type="checkbox"/> Wave/Twist in Tube           | <input type="checkbox"/> Folio          | <input type="checkbox"/> Outside Dimensions              |
|   |   | <input type="checkbox"/> Ovalized                        |
|   |   | <input type="checkbox"/> Over/Under tolerance            |
|   |   | <input type="checkbox"/> Part Incorrect                  |
|   |   | <input type="checkbox"/> Part Lost/Missing               |
|   |   | <input type="checkbox"/> Part Moved                      |
|   |   | <input type="checkbox"/> Positioned Wrong                |
|   |   | <input type="checkbox"/> Power Loss/Surge                |
|   |   | <input type="checkbox"/> Pressure/Forced                 |
|   |   | <input type="checkbox"/> Temperature/Cure                |
|   |   | <input type="checkbox"/> Weld                            |
|   |   | <input type="checkbox"/> Wrong Stock Pulled              |
|   |   | <input type="checkbox"/> Other                           |



# Picklist Print

Friday, November 09, 2012 3:57:12 PM

Page 1

Work Order ID: 92883  
Parent Item: D139-799-012  
Parent Item Name: Maintenance Step

Start Date: 11/9/2012

Required Date: 11/16/2012

Start Qty: 4.00

Required Qty: 4.00




Comments: IPP REV:A NEW ISSUE 10-10-20 JLM VERIFIED BY:DD IPP REV:B AS PER ECN 11-598 11-06-05 JLM VERF BY:DD IPP Rev:C 11.09.27 PER CHG003 DD verf:EC  
IPP Rev:D 12.10.31 PER CHG004 DD verf:JLM

| Component Item ID/<br>Item Name  | Replacement<br>Item ID | Mfg/<br>Purch | Bin<br>Item | Primary<br>Location | Last<br>Location | Route<br>Seq ID | Unit of<br>Measure | Qty on<br>Hand  | Qty per Kit | Total<br>Qty | Qty<br>Issued | Date<br>Issued | Status |
|----------------------------------|------------------------|---------------|-------------|---------------------|------------------|-----------------|--------------------|-----------------|-------------|--------------|---------------|----------------|--------|
| AN6H12<br>Bolt                   |                        | Purchased     | No          |                     |                  |                 | Each               | 16.0000         |             | -16          |               | 12/3/09        | SL     |
|                                  |                        |               |             | <u>Location</u>     |                  | <u>Loc Qty</u>  |                    | <u>Loc Code</u> |             |              |               |                |        |
|                                  |                        |               |             | ST341               |                  | 16              |                    |                 |             |              |               |                |        |
|                                  |                        |               |             | 121340              |                  | 16              |                    |                 |             |              |               |                |        |
| AN6H12A<br>Bolt                  |                        | Purchased     | No          |                     |                  |                 | Each               | 50.0000         |             |              |               |                | SL     |
|                                  |                        |               |             | <u>Location</u>     |                  | <u>Loc Qty</u>  |                    | <u>Loc Code</u> |             |              |               |                |        |
|                                  |                        |               |             | ST339               |                  | 50              |                    |                 |             |              |               |                |        |
|                                  |                        |               |             | 123556              |                  | 50              |                    |                 |             |              |               |                |        |
| AN6H13A<br>Bolt                  |                        | Purchased     | No          |                     |                  |                 | Each               | 30.0000         |             |              |               |                | SL     |
|                                  |                        |               |             | <u>Location</u>     |                  | <u>Loc Qty</u>  |                    | <u>Loc Code</u> |             |              |               |                |        |
|                                  |                        |               |             | ST339               |                  | 30              |                    |                 |             |              |               |                |        |
|                                  |                        |               |             | 123556              |                  | 30              |                    |                 |             |              |               |                |        |
| D139-799-012<br>Maintenance Step |                        | Manufactured  | No          |                     |                  |                 | Each               | 1.0000          |             |              |               |                |        |
|                                  |                        |               |             | <u>Location</u>     |                  | <u>Loc Qty</u>  |                    | <u>Loc Code</u> |             |              |               |                |        |
|                                  |                        |               |             | FG                  |                  | 1               |                    |                 |             |              |               |                |        |
|                                  |                        |               |             | 80906               |                  | 1               |                    |                 |             |              |               |                |        |

MAX

1 x 82763  
3 x 82143

ME  
12-11-09  
12-11-13

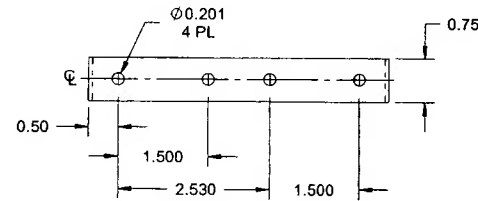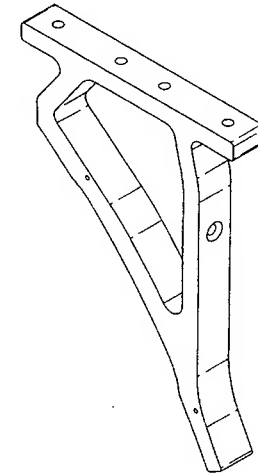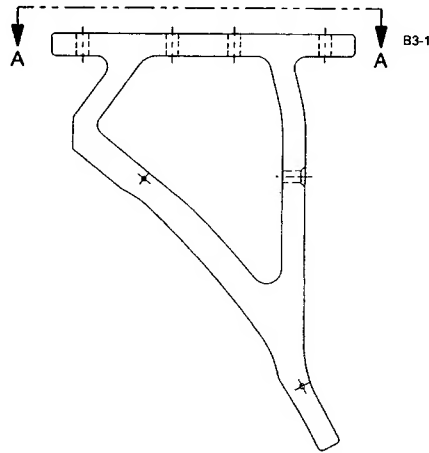

SECTION VIEW A-A D6-1

NOTES:

- 1) MATERIAL: 6061-T6/T651/T6511/T62 ALUMINUM BAR  
PER QQ-A-225/8 OR AMS-QQ-A-225/8 (OR AMS 4117/4128/4115/4116)  
OR QQ-A-200/8 OR AMS-QQ-A-200/8 (OR AMS 4160)  
OR ASTM B211 OR ASTM B221  
OR 6061-T6/T62 ALUMINUM SHEET  
PER QQ-A-250/11 OR AMS-QQ-A-250/11  
OR AMS 4025 OR AMS 4027  
OR ASTM B209  
REF DART SPEC. M6061T6B/M6061T6S
- 2) FINISH: CHEMICAL CONVERSION COAT PER DART QSI 005 4.1
- 3) TOLERANCES: PER DART QSI 018 UNLESS OTHERWISE NOTED
- 4) UNITS: INCHES UNLESS OTHERWISE NOTED
- 5) BREAK SHARP EDGES: 0.005 TO 0.010 MAX
- 6) IDENTIFICATION: NONE
- 7) WEIGHT: 0.55 lbs

**D4093-1 BRACKET**

| D          | ADD Ø 0.080 HOLES (ZN B5-2, B5-4)  | RF  | 12.09.18     |
|------------|--|---|--------------|
| C          | REDRAWN D4093-1/-3 (ZN B4-1, B4-2); ADD MATERIAL NOTES (ZN A8-1, A8-3, A8-5) | RF  | 11.07.27     |
| B          | REDRAWN D4093-1/-3 (ZN B4-1, B4-2)   | RF  | 11.01.31     |
| A          | NEW ISSUE  | RF  | 10.09.16     |
| REV.       | DESCRIPTION  | BY  | DATE         |
| DESIGN     | RF   | <b>DART AEROSPACE USA, INC.</b><br>KENT, WA   |              |
| DRAWN      | RF   |   |              |
| CHECKED    | RF   | DRAWING NO.   | REV. D       |
| MFG. APPR. | RF   | <b>D4093</b>  | SHEET 1 OF 5 |
| APPROVED   | RF   | TITLE   | SCALE        |
| DE APPR.   | RF   | <b>BRACKET</b>  | NTS          |
| DATE       | 12.09.18   | COPYRIGHT © 2010 BY DART AEROSPACE USA, INC.<br>THIS DOCUMENT IS PRIVATE AND CONFIDENTIAL AND IS SUPPLIED ON THE EXPRESS CONDITION THAT IT IS NOT TO BE USED FOR ANY PURPOSE OR COPIED OR COMMUNICATED TO ANY OTHER PERSON WITHOUT WRITTEN PERMISSION FROM DART AEROSPACE USA, INC. |              |

RELEASED  
2012-10-31



NCR: Yes / No

**WORK ORDER NON-CONFORMANCE / UPDATE**

DQA: \_\_\_\_\_ Date: \_\_\_\_\_

QA Closed: \_\_\_\_\_ Date: \_\_\_\_\_

|   |      |      |   |   |                   |   |             |              |   |  |  |
|---|------|------|---|---|-------------------|---|-------------|--------------|---|--|--|
| Work Order: _____<br><br>Part No. _____<br><br>NCR No. _____  |      |      |   | <b>DISPOSITION</b><br><br>Rework <input type="checkbox"/><br>Scrap <input type="checkbox"/><br>Use-as-is <input type="checkbox"/><br>Work Order Update <input type="checkbox"/> |                   | <b>AGAINST DEPARTMENT/PROCESS</b><br><br><div style="display: flex; justify-content: space-between;"> <div>           Skid-tube <input type="checkbox"/><br/>           Machining <input type="checkbox"/><br/>           Thermoforming <input type="checkbox"/><br/>           Large Fab <input type="checkbox"/> </div> <div>           Crosstube <input type="checkbox"/><br/>           Small Fab <input type="checkbox"/><br/>           Finishing <input type="checkbox"/><br/>           Composite <input type="checkbox"/> </div> <div>           Water Jet <input type="checkbox"/><br/>           Prod. Eng. Coord. <input type="checkbox"/><br/>           Rec/Store/Packaging <input type="checkbox"/><br/>           Supplier <input type="checkbox"/> </div> <div>           Engineering <input type="checkbox"/><br/>           Quality <input type="checkbox"/><br/>           Other <input type="checkbox"/> </div> </div> |             |              |   |  |  |
| Root Cause  | Date | Step | Qty   | Description of work order update or Non-conformance   | Initial Chief Eng | Action Description  | Sign & Date | Verification | QC Inspector  |  |  |
| Doc/Data  |      |      |   |   |                   |   |             |              |   |  |  |
| Equip/Tooling   |      |      |   |   |                   |   |             |              |   |  |  |
| Operator  |      |      |   |   |                   |   |             |              |   |  |  |
| Material  |      |      |   |   |                   |   |             |              |   |  |  |
| Setup   |      |      |   |   |                   |   |             |              |   |  |  |
| Other   |      |      |   |   |                   |   |             |              |   |  |  |
| Process   |      |      |   |   |                   |   |             |              |   |  |  |
| Supplier  |      |      |   |   |                   |   |             |              |   |  |  |
| Training  |      |      |   |   |                   |   |             |              |   |  |  |
| Unapproved  |      |      |   |   |                   |   |             |              |   |  |  |
| <b>FAULT CATEGORY</b>   |      |      |   |   |                   |   |             |              |   |  |  |
| <b>Landing Gear</b><br><input type="checkbox"/> Bending<br><input type="checkbox"/> Centre Not Concentric to O/S<br><input type="checkbox"/> Cracks<br><input type="checkbox"/> Crushed/Crimped<br><input type="checkbox"/> Cuffs<br><input type="checkbox"/> Heat Treat<br><input type="checkbox"/> Inspection Strip in Tube<br><input type="checkbox"/> Ripples in Bend<br><input type="checkbox"/> Torque Waves in Extrusion<br><input type="checkbox"/> Turning Sequence<br><input type="checkbox"/> Wave/Twist in Tube |      |      | <b>General</b><br><input type="checkbox"/> Bend<br><input type="checkbox"/> BOM/Route<br><input type="checkbox"/> Broken/Damaged<br><input type="checkbox"/> Burrs<br><input type="checkbox"/> Contamination<br><input type="checkbox"/> Countersink<br><input type="checkbox"/> Cut Too Short<br><input type="checkbox"/> Drill Holes<br><input type="checkbox"/> Drawing<br><input type="checkbox"/> Finish<br><input type="checkbox"/> Folio |   |                   | <input type="checkbox"/> Grain<br><input type="checkbox"/> Hardware<br><input type="checkbox"/> Inspection Incomplete<br><input type="checkbox"/> Instructions Incomplete/Unclear<br><input type="checkbox"/> Maintenance<br><input type="checkbox"/> Mislabeled<br><input type="checkbox"/> Misread<br><input type="checkbox"/> Offset<br><input type="checkbox"/> Out of Calibration<br><input type="checkbox"/> Out of Sequence<br><input type="checkbox"/> Outside Dimensions   |             |              | <input type="checkbox"/> Ovalized<br><input type="checkbox"/> Over/Under tolerance<br><input type="checkbox"/> Part Incorrect<br><input type="checkbox"/> Part Lost/Missing<br><input type="checkbox"/> Part Moved<br><input type="checkbox"/> Positioned Wrong<br><input type="checkbox"/> Power Loss/Surge<br><br><input type="checkbox"/> Pressure/Forced<br><input type="checkbox"/> Temperature/Cure<br><input type="checkbox"/> Weld<br><input type="checkbox"/> Wrong Stock Pulled<br><input type="checkbox"/> Other |  |  |

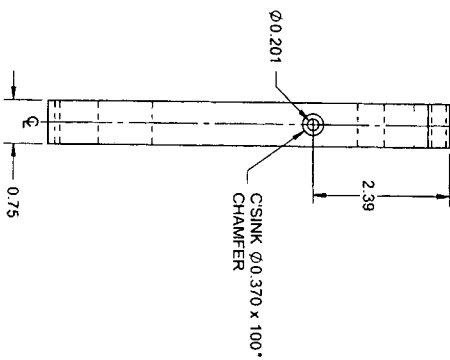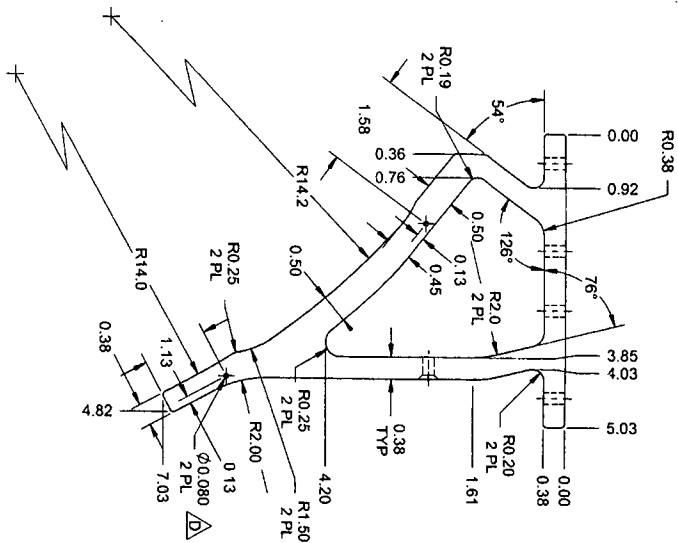

D4093-1 BRACKET

| DESIGN     | RE       | RE | DART AEROSPACE USA, INC. |
|------------|----------|----|--------------------------|
| DRAWN      | RF       | RF | KENT, WA                 |
| CHECKED    | RF       | RF | DRAWING NO.              |
| MFG. APPR. | RF       | RF | D4093                    |
| APPROVED   | RF       | RF | REV. D                   |
| DE APPR.   | RF       | RF | SHEET 2 OF 5             |
| DATE       | 12.09.18 | RF | SCALE                    |
|            |          | RF | NTS                      |
|            |          | RF | BRACKET                  |

RELEASED  
2012-10-31  
JMI

COPYRIGHT © 2018 BY DART AEROSPACE USA, INC. ALL RIGHTS RESERVED. NO PART OF THIS DOCUMENT MAY BE REPRODUCED OR TRANSMITTED IN ANY FORM OR BY ANY MEANS WITHOUT PERMISSION IN WRITING FROM DART AEROSPACE USA, INC.




NCR: Yes / No

**WORK ORDER NON-CONFORMANCE / UPDATE**

DQA: \_\_\_\_\_ Date: \_\_\_\_\_

QA Closed: \_\_\_\_\_ Date: \_\_\_\_\_

|   |                                    |---|------------------------------------|--|---|---|--------------------------|--|------------------------|---------------------|---|--|--|------------------------------------|------------------------------------|------------------------------------|--------------------------------------|------------------------------------|------------------------------------|--|----------------------------------|--|------------------------------------|--|--------------------------------|------------------------------------|------------------------------------|-----------------------------------|--|
| Work Order: _____<br><br>Part No. _____<br><br>NCR No. _____  |                                    |  |   | <b>DISPOSITION</b><br><br>Rework <input type="checkbox"/><br>Scrap <input type="checkbox"/><br>Use-as-is <input type="checkbox"/><br>Work Order Update <input type="checkbox"/> |                          | <b>AGAINST DEPARTMENT/PROCESS</b><br><br><table style="width:100%; border: none;"> <tr> <td style="width:25%;">Skid-tube <input type="checkbox"/></td> <td style="width:25%;">Crosstube <input type="checkbox"/></td> <td style="width:25%;">Water Jet <input type="checkbox"/></td> <td style="width:25%;">Engineering <input type="checkbox"/></td> </tr> <tr> <td>Machining <input type="checkbox"/></td> <td>Small Fab <input type="checkbox"/></td> <td>Prod. Eng. Coord. <input type="checkbox"/></td> <td>Quality <input type="checkbox"/></td> </tr> <tr> <td>Thermoforming <input type="checkbox"/></td> <td>Finishing <input type="checkbox"/></td> <td>Rec/Store/Packaging <input type="checkbox"/></td> <td>Other <input type="checkbox"/></td> </tr> <tr> <td>Large Fab <input type="checkbox"/></td> <td>Composite <input type="checkbox"/></td> <td>Supplier <input type="checkbox"/></td> <td></td> </tr> </table> |                        |                     |   |  |  | Skid-tube <input type="checkbox"/> | Crosstube <input type="checkbox"/> | Water Jet <input type="checkbox"/> | Engineering <input type="checkbox"/> | Machining <input type="checkbox"/> | Small Fab <input type="checkbox"/> | Prod. Eng. Coord. <input type="checkbox"/> | Quality <input type="checkbox"/> | Thermoforming <input type="checkbox"/> | Finishing <input type="checkbox"/> | Rec/Store/Packaging <input type="checkbox"/> | Other <input type="checkbox"/> | Large Fab <input type="checkbox"/> | Composite <input type="checkbox"/> | Supplier <input type="checkbox"/> |  |
| Skid-tube <input type="checkbox"/>  | Crosstube <input type="checkbox"/> | Water Jet <input type="checkbox"/>           | Engineering <input type="checkbox"/>  |   |                          | Machining <input type="checkbox"/>  | Small Fab <input type="checkbox"/> | Prod. Eng. Coord. <input type="checkbox"/>   | Quality <input type="checkbox"/>  |   |                          | Thermoforming <input type="checkbox"/>  | Finishing <input type="checkbox"/> | Rec/Store/Packaging <input type="checkbox"/> | Other <input type="checkbox"/>  |   |                          | Large Fab <input type="checkbox"/>  | Composite <input type="checkbox"/> | Supplier <input type="checkbox"/>            |   |   | <b>Root Cause</b>   | <b>Date</b>                        | <b>Step</b>                                  | <b>Qty</b>  | <b>Description of work order update or Non-conformance</b>  | <b>Initial Chief Eng</b> | <b>Action Description</b>  | <b>Sign &amp; Date</b> | <b>Verification</b> | <b>QC Inspector</b>   |  |  |                                    |                                    |                                    |                                      |                                    |                                    |  |                                  |  |                                    |  |                                |                                    |                                    |                                   |  |
| Doc/Data <input type="checkbox"/>   |                                    |  | Equip/Tooling <input type="checkbox"/>  |                                    |  | Operator <input type="checkbox"/>   |                                    |  | Material <input type="checkbox"/>   |                                    |  | Setup <input type="checkbox"/>  |                                    |  | Other <input type="checkbox"/>  |                                    |  | Process <input type="checkbox"/>  |                                    |  | Supplier <input type="checkbox"/>   |                                    |  | Training <input type="checkbox"/>   |                                    |  | Unapproved <input type="checkbox"/>   |                                    |  | <b>FAULT CATEGORY</b>   |                                    |  | <b>Landing Gear</b><br><input type="checkbox"/> Bending<br><input type="checkbox"/> Centre Not Concentric to O/S<br><input type="checkbox"/> Cracks<br><input type="checkbox"/> Crushed/Crimped<br><input type="checkbox"/> Cuffs<br><input type="checkbox"/> Heat Treat<br><input type="checkbox"/> Inspection Strip in Tube<br><input type="checkbox"/> Ripples in Bend<br><input type="checkbox"/> Torque Waves in Extrusion<br><input type="checkbox"/> Turning Sequence<br><input type="checkbox"/> Wave/Twist in Tube |                                    |  | <b>General</b><br><input type="checkbox"/> Bend<br><input type="checkbox"/> BOM/Route<br><input type="checkbox"/> Broken/Damaged<br><input type="checkbox"/> Burrs<br><input type="checkbox"/> Contamination<br><input type="checkbox"/> Countersink<br><input type="checkbox"/> Cut Too Short<br><input type="checkbox"/> Drill Holes<br><input type="checkbox"/> Drawing<br><input type="checkbox"/> Finish<br><input type="checkbox"/> Folio |   |                          | <input type="checkbox"/> Grain<br><input type="checkbox"/> Hardware<br><input type="checkbox"/> Inspection Incomplete<br><input type="checkbox"/> Instructions Incomplete/Unclear<br><input type="checkbox"/> Maintenance<br><input type="checkbox"/> Mislabeled<br><input type="checkbox"/> Misread<br><input type="checkbox"/> Offset<br><input type="checkbox"/> Out of Calibration<br><input type="checkbox"/> Out of Sequence<br><input type="checkbox"/> Outside Dimensions  |                        |                     | <input type="checkbox"/> Ovalized<br><input type="checkbox"/> Over/Under tolerance<br><input type="checkbox"/> Part Incorrect<br><input type="checkbox"/> Part Lost/Missing<br><input type="checkbox"/> Part Moved<br><input type="checkbox"/> Positioned Wrong<br><input type="checkbox"/> Power Loss/Surge<br><br>_____<br>_____<br>_____ |  | <input type="checkbox"/> Pressure/Forced<br><input type="checkbox"/> Temperature/Cure<br><input type="checkbox"/> Weld<br><input type="checkbox"/> Wrong Stock Pulled<br><br><input type="checkbox"/> Other<br>_____<br>_____<br>_____ |                                    |                                    |                                    |                                      |                                    |                                    |  |                                  |  |                                    |  |                                |                                    |                                    |                                   |  |

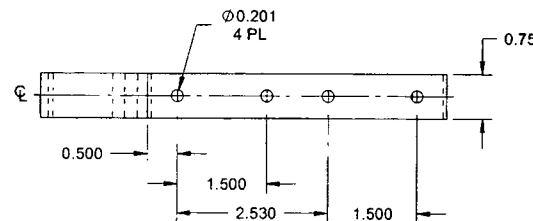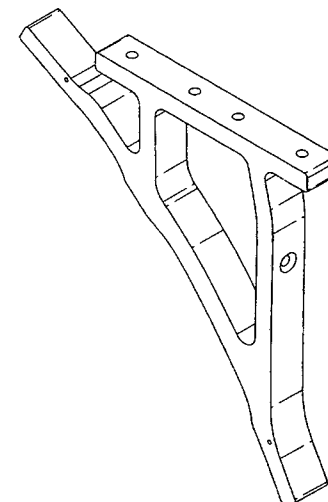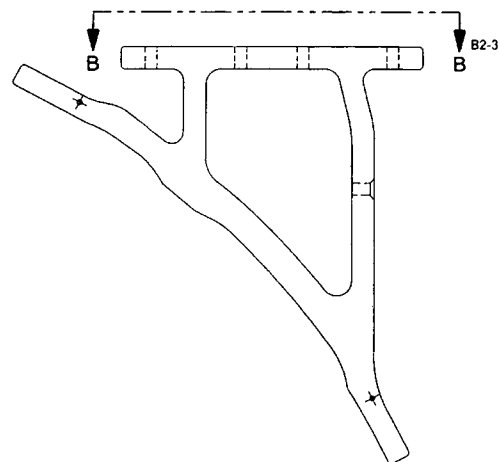





# **D4093-3 BRACKET**

## **SECTION VIEW B-B B5-3**

### **NOTES:**

- 1) MATERIAL: 6061-T6/T651/T6510/T6511/T62 ALUMINUM BAR  
PER QQ-A-225/8 OR AMS-QQ-A-225/8 (OR AMS 4117/4128/4115/4116)  
OR QQ-A-200/8 OR AMS-QQ-A-200/8 (OR AMS 4160)  
OR ASTM B211 OR ASTM B221  
OR 6061-T6/T62 ALUMINUM SHEET  
PER QQ-A-250/11 OR AMS-QQ-A-250/11  
OR AMS 4025 OR AMS 4027  
OR ASTM B209  
REF DART SPEC. M6061T6B/M6061T6S
- 2) FINISH: CHEMICAL CONVERSION COAT PER DART QSI 005 4.1
- 3) TOLERANCES: PER DART QSI 018 UNLESS OTHERWISE NOTED
- 4) UNITS: INCHES UNLESS OTHERWISE NOTED
- 5) BREAK SHARP EDGES: 0.005 TO 0.010 MAX
- 6) IDENTIFICATION: NONE
- 7) WEIGHT: 0.64 lbs"

**RELEASED**  
2012-10-31  
JMP

|   |   |  |              |
|---|---|--|--------------|
| DESIGN  | RF  | <b>DART AEROSPACE USA, INC.</b>              |              |
| DRAWN   | RF  | KENT, WA                                     |              |
| CHECKED   |  | DRAWING NO.                                  | REV. D       |
| MFG. APPR.  |  | <b>D4093</b>                                 | SHEET 3 OF 5 |
| APPROVED  |  | TITLE  | SCALE        |
| DE APPR.  |  | <b>BRACKET</b>                               | NTS          |
| DATE  | 12.09.18  | COPYRIGHT © 2010 BY DART AEROSPACE USA, INC. |              |
| THIS DOCUMENT IS PRIVATE AND CONFIDENTIAL AND IS SUPPLIED ON THE EXPRESS CONDITION THAT IT IS NOT TO BE USED FOR ANY PURPOSE OR COMMUNICATED TO ANY OTHER PERSON WITHOUT WRITTEN PERMISSION FROM DART AEROSPACE USA, INC. |   |  |              |



NCR: Yes / No

**WORK ORDER NON-CONFORMANCE / UPDATE**

DQA: \_\_\_\_\_ Date: \_\_\_\_\_

QA Closed: \_\_\_\_\_ Date: \_\_\_\_\_

|   |      |      |   |   |                      |   |                |              |   |  |  |
|---|------|------|---|---|----------------------|---|----------------|--------------|---|--|--|
| Work Order: _____<br><br>Part No. _____<br><br>NCR No. _____  |      |      |   | <b>DISPOSITION</b><br><br>Rework <input type="checkbox"/><br>Scrap <input type="checkbox"/><br>Use-as-is <input type="checkbox"/><br>Work Order Update <input type="checkbox"/> |                      | <b>AGAINST DEPARTMENT/PROCESS</b><br><br><div style="display: flex; justify-content: space-between;"> <div>           Skid-tube <input type="checkbox"/><br/>           Machining <input type="checkbox"/><br/>           Thermoforming <input type="checkbox"/><br/>           Large Fab <input type="checkbox"/> </div> <div>           Crosstube <input type="checkbox"/><br/>           Small Fab <input type="checkbox"/><br/>           Finishing <input type="checkbox"/><br/>           Composite <input type="checkbox"/> </div> <div>           Water Jet <input type="checkbox"/><br/>           Prod. Eng. Coord. <input type="checkbox"/><br/>           Rec/Store/Packaging <input type="checkbox"/><br/>           Supplier <input type="checkbox"/> </div> <div>           Engineering <input type="checkbox"/><br/>           Quality <input type="checkbox"/><br/>           Other <input type="checkbox"/> </div> </div> |                |              |   |  |  |
| <b>Root Cause</b>   | Date | Step | Qty   | Description of work order update<br>or Non-conformance  | Initial<br>Chief Eng | Action<br>Description   | Sign &<br>Date | Verification | QC Inspector  |  |  |
| Doc/Data <input type="checkbox"/>   |      |      |   |   |                      |   |                |              |   |  |  |
| Equip/Tooling <input type="checkbox"/>  |      |      |   |   |                      |   |                |              |   |  |  |
| Operator <input type="checkbox"/>   |      |      |   |   |                      |   |                |              |   |  |  |
| Material <input type="checkbox"/>   |      |      |   |   |                      |   |                |              |   |  |  |
| Setup <input type="checkbox"/>  |      |      |   |   |                      |   |                |              |   |  |  |
| Other <input type="checkbox"/>  |      |      |   |   |                      |   |                |              |   |  |  |
| Process <input type="checkbox"/>  |      |      |   |   |                      |   |                |              |   |  |  |
| Supplier <input type="checkbox"/>   |      |      |   |   |                      |   |                |              |   |  |  |
| Training <input type="checkbox"/>   |      |      |   |   |                      |   |                |              |   |  |  |
| Unapproved <input type="checkbox"/>   |      |      |   |   |                      |   |                |              |   |  |  |
| <b>FAULT CATEGORY</b>   |      |      |   |   |                      |   |                |              |   |  |  |
| <b>Landing Gear</b><br><input type="checkbox"/> Bending<br><input type="checkbox"/> Centre Not Concentric to O/S<br><input type="checkbox"/> Cracks<br><input type="checkbox"/> Crushed/Crimped<br><input type="checkbox"/> Cuffs<br><input type="checkbox"/> Heat Treat<br><input type="checkbox"/> Inspection Strip in Tube<br><input type="checkbox"/> Ripples in Bend<br><input type="checkbox"/> Torque Waves in Extrusion<br><input type="checkbox"/> Turning Sequence<br><input type="checkbox"/> Wave/Twist in Tube |      |      | <b>General</b><br><input type="checkbox"/> Bend<br><input type="checkbox"/> BOM/Route<br><input type="checkbox"/> Broken/Damaged<br><input type="checkbox"/> Burrs<br><input type="checkbox"/> Contamination<br><input type="checkbox"/> Countersink<br><input type="checkbox"/> Cut Too Short<br><input type="checkbox"/> Drill Holes<br><input type="checkbox"/> Drawing<br><input type="checkbox"/> Finish<br><input type="checkbox"/> Folio |   |                      | <input type="checkbox"/> Grain<br><input type="checkbox"/> Hardware<br><input type="checkbox"/> Inspection Incomplete<br><input type="checkbox"/> Instructions Incomplete/Unclear<br><input type="checkbox"/> Maintenance<br><input type="checkbox"/> Mislabeled<br><input type="checkbox"/> Misread<br><input type="checkbox"/> Offset<br><input type="checkbox"/> Out of Calibration<br><input type="checkbox"/> Out of Sequence<br><input type="checkbox"/> Outside Dimensions   |                |              | <input type="checkbox"/> Ovalized<br><input type="checkbox"/> Over/Under tolerance<br><input type="checkbox"/> Part Incorrect<br><input type="checkbox"/> Part Lost/Missing<br><input type="checkbox"/> Part Moved<br><input type="checkbox"/> Positioned Wrong<br><input type="checkbox"/> Power Loss/Surge<br><br><input type="checkbox"/> Pressure/Forced<br><input type="checkbox"/> Temperature/Cure<br><input type="checkbox"/> Weld<br><input type="checkbox"/> Wrong Stock Pulled<br><br><input type="checkbox"/> Other |  |  |

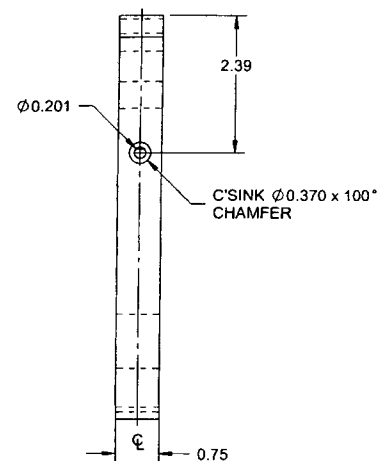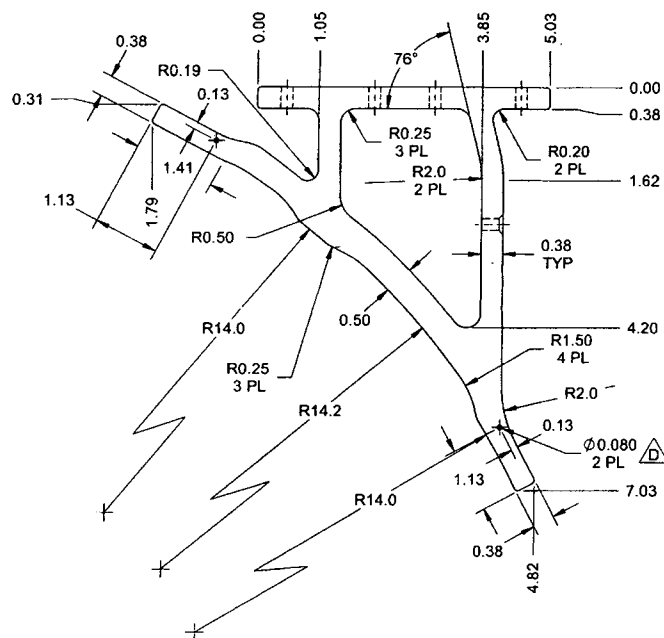

**D4093-3 BRACKET**

**RELEASED**  
2012-10-31  
ND

|            |                    |   |              |
|------------|--------------------|---|--------------|
| DESIGN     | RF                 | <b>DART AEROSPACE USA, INC.</b>   |              |
| DRAWN      | RF                 | KENT, WA  |              |
| CHECKED    | <i>[Signature]</i> | DRAWING NO.   | REV. D       |
| MFG. APPR. | <i>[Signature]</i> | <b>D4093</b>  | SHEET 4 OF 5 |
| APPROVED   | <i>[Signature]</i> | TITLE   | SCALE        |
| DE APPR.   | <i>[Signature]</i> | <b>BRACKET</b>  | NTS          |
| DATE       | 12.09.18           | <small>COPYRIGHT © 2010 BY DART AEROSPACE USA, INC.<br/>THIS DOCUMENT IS PRIVATE AND CONFIDENTIAL AND IS SUPPLIED ON THE EXPRESS CONDITION THAT IT IS NOT TO BE USED FOR ANY PURPOSE OR COMMUNICATED TO ANY OTHER PERSON WITHOUT WRITTEN PERMISSION FROM DART AEROSPACE USA, INC.</small> |              |



NCR: Yes / No


**WORK ORDER NON-CONFORMANCE / UPDATE**

DQA: \_\_\_\_\_ Date: \_\_\_\_\_

QA Closed: \_\_\_\_\_ Date: \_\_\_\_\_

|  |      |      |     |   |                   |   |             |              |              |  |  |
|--|------|------|-----|---|-------------------|---|-------------|--------------|--------------|--|--|
| Work Order: _____<br><br>Part No. _____<br><br>NCR No. _____ |      |      |     | <b>DISPOSITION</b><br><br>Rework <input type="checkbox"/><br>Scrap <input type="checkbox"/><br>Use-as-is <input type="checkbox"/><br>Work Order Update <input type="checkbox"/> |                   | <b>AGAINST DEPARTMENT/PROCESS</b><br><br><div style="display: flex; justify-content: space-between;"> <div>           Skid-tube <input type="checkbox"/><br/>           Machining <input type="checkbox"/><br/>           Thermoforming <input type="checkbox"/><br/>           Large Fab <input type="checkbox"/> </div> <div>           Crosstube <input type="checkbox"/><br/>           Small Fab <input type="checkbox"/><br/>           Finishing <input type="checkbox"/><br/>           Composite <input type="checkbox"/> </div> <div>           Water Jet <input type="checkbox"/><br/>           Prod. Eng. Coord. <input type="checkbox"/><br/>           Rec/Store/Packaging <input type="checkbox"/><br/>           Supplier <input type="checkbox"/> </div> <div>           Engineering <input type="checkbox"/><br/>           Quality <input type="checkbox"/><br/>           Other <input type="checkbox"/> </div> </div> |             |              |              |  |  |
| Root Cause   | Date | Step | Qty | Description of work order update or Non-conformance   | Initial Chief Eng | Action Description  | Sign & Date | Verification | QC Inspector |  |  |
| Doc/Data   |      |      |     |   |                   |   |             |              |              |  |  |
| Equip/Tooling  |      |      |     |   |                   |   |             |              |              |  |  |
| Operator   |      |      |     |   |                   |   |             |              |              |  |  |
| Material   |      |      |     |   |                   |   |             |              |              |  |  |
| Setup  |      |      |     |   |                   |   |             |              |              |  |  |
| Other  |      |      |     |   |                   |   |             |              |              |  |  |
| Process  |      |      |     |   |                   |   |             |              |              |  |  |
| Supplier   |      |      |     |   |                   |   |             |              |              |  |  |
| Training   |      |      |     |   |                   |   |             |              |              |  |  |
| Unapproved   |      |      |     |   |                   |   |             |              |              |  |  |

| FAULT CATEGORY                    |   |  |  |  |   |   |  |  |   |   |
|-----------------------------------|---|--|--|--|---|---|--|--|---|---|
| <b>Landing Gear</b>               |   |  | <b>General</b>   |  |   | <b>Grain</b>                                      |  | <b>Other</b>                                       |   |   |
| <input type="checkbox"/> Bending  | <input type="checkbox"/> Centre Not Concentric to O/S | <input type="checkbox"/> Cracks                | <input type="checkbox"/> Crushed/Crimped                 | <input type="checkbox"/> Cuffs         | <input type="checkbox"/> Heat Treat       | <input type="checkbox"/> Inspection Strip in Tube | <input type="checkbox"/> Ripples in Bend | <input type="checkbox"/> Torque Waves in Extrusion | <input type="checkbox"/> Turning Sequence | <input type="checkbox"/> Wave/Twist in Tube |
| <input type="checkbox"/> Bend     | <input type="checkbox"/> BOM/Route                    | <input type="checkbox"/> Broken/Damaged        | <input type="checkbox"/> Burrs                           | <input type="checkbox"/> Contamination | <input type="checkbox"/> Countersink      | <input type="checkbox"/> Cut Too Short            | <input type="checkbox"/> Drill Holes     | <input type="checkbox"/> Drawing                   | <input type="checkbox"/> Finish           | <input type="checkbox"/> Folio              |
| <input type="checkbox"/> Grain    | <input type="checkbox"/> Hardware                     | <input type="checkbox"/> Inspection Incomplete | <input type="checkbox"/> Instructions Incomplete/Unclear | <input type="checkbox"/> Maintenance   | <input type="checkbox"/> Mislabeled       | <input type="checkbox"/> Misread                  | <input type="checkbox"/> Offset          | <input type="checkbox"/> Out of Calibration        | <input type="checkbox"/> Out of Sequence  | <input type="checkbox"/> Outside Dimensions |
| <input type="checkbox"/> Ovalized | <input type="checkbox"/> Over/Under tolerance         | <input type="checkbox"/> Part Incorrect        | <input type="checkbox"/> Part Lost/Missing               | <input type="checkbox"/> Part Moved    | <input type="checkbox"/> Positioned Wrong | <input type="checkbox"/> Power Loss/Surge         | <input type="checkbox"/> Pressure/Forced | <input type="checkbox"/> Temperature/Cure          | <input type="checkbox"/> Weld             | <input type="checkbox"/> Wrong Stock Pulled |
|                                   |   |  |  |  |   | <input type="checkbox"/> Other                    |  |  |   |   |
|                                   |   |  |  |  |   |   |  |  |   |   |
|                                   |   |  |  |  |   |   |  |  |   |   |
|                                   |   |  |  |  |   |   |  |  |   |   |

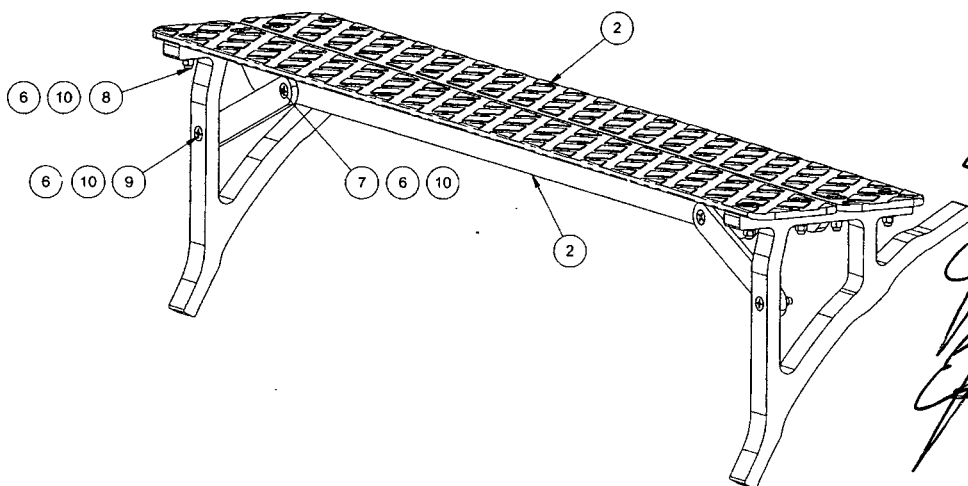

**D4092-042 MAINTENANCE STEP ASSEMBLY**



| ITEM | QTY | P/N           | DESCRIPTION               |
|------|-----|---------------|---------------------------|
| 1    | X   | D4092-042     | MAINTENANCE STEP ASSEMBLY |
| 2    | 2   | D4092-1       | MAINTENANCE STEP          |
| 3    | 1   | D4093-1       | BRACKET                   |
| 4    | 1   | D4093-3       | BRACKET                   |
| 5    | 2   | D4093-5       | BRACKET                   |
| 6    | 12  | MS21042L3     | NUT                       |
| 7    | 2   | MS24694-S54   | SCREW                     |
| 8    | 8   | MS24694-S55   | SCREW                     |
| 9    | 2   | MS24694-S56   | SCREW                     |
| 10   | 12  | WAS1149D0332J | WASHER                    |

MS24694-S55  
B# M122151 (320)

MS24694-S56  
B# M121340 (8X)

MS21042L3  
B# M122452 (40X)

WAS1149D0332J  
M122773 (40X)

**RELEASED**  
2011-09-22  
JUN

|            |          |   |              |
|------------|----------|---|--------------|
| DESIGN     | RF       | DART AEROSPACE USA, INC.  |              |
| DRAWN      | RF       | KENT, WA  |              |
| CHECKED    | MP       | DRAWING NO.   | REV. B       |
| MFG. APPR. | MP       | D4092   | SHEET 2 OF 6 |
| APPROVED   | MP       | TITLE   | SCALE        |
| DE APPR.   | MP       | MAINTENANCE STEP ASS'Y  | NTS          |
| DATE       | 11.07.27 | <small>COPYRIGHT © 2010 BY DART AEROSPACE USA, INC.<br/>THIS DOCUMENT IS PRIVATE AND CONFIDENTIAL AND IS SUPPLIED ON THE EXPRESS CONDITION THAT IT IS NOT TO BE USED FOR ANY PURPOSE OR COPIED OR COMMUNICATED TO ANY OTHER PERSON WITHOUT WRITTEN PERMISSION FROM DART AEROSPACE USA, INC.</small> |              |




NCR: Yes / No

## WORK ORDER NON-CONFORMANCE / UPDATE

DQA: \_\_\_\_\_ Date: \_\_\_\_\_

QA Closed: \_\_\_\_\_ Date: \_\_\_\_\_

|   |             |             |   |   |                          |   |                        |                     |   |  |  |
|---|-------------|-------------|---|---|--------------------------|---|------------------------|---------------------|---|--|--|
| Work Order: _____<br><br>Part No. _____<br><br>NCR No. _____  |             |             |   | <b>DISPOSITION</b><br><br>Rework <input type="checkbox"/><br>Scrap <input type="checkbox"/><br>Use-as-is <input type="checkbox"/><br>Work Order Update <input type="checkbox"/> |                          | <b>AGAINST DEPARTMENT/PROCESS</b><br><br><div style="display: flex; justify-content: space-between;"> <div>           Skid-tube <input type="checkbox"/><br/>           Machining <input type="checkbox"/><br/>           Thermoforming <input type="checkbox"/><br/>           Large Fab <input type="checkbox"/> </div> <div>           Crosstube <input type="checkbox"/><br/>           Small Fab <input type="checkbox"/><br/>           Finishing <input type="checkbox"/><br/>           Composite <input type="checkbox"/> </div> <div>           Water Jet <input type="checkbox"/><br/>           Prod. Eng. Coord. <input type="checkbox"/><br/>           Rec/Store/Packaging <input type="checkbox"/><br/>           Supplier <input type="checkbox"/> </div> <div>           Engineering <input type="checkbox"/><br/>           Quality <input type="checkbox"/><br/>           Other <input type="checkbox"/> </div> </div> |                        |                     |   |  |  |
| <b>Root Cause</b>   | <b>Date</b> | <b>Step</b> | <b>Qty</b>  | <b>Description of work order update or Non-conformance</b>  | <b>Initial Chief Eng</b> | <b>Action Description</b>   | <b>Sign &amp; Date</b> | <b>Verification</b> | <b>QC Inspector</b>   |  |  |
| Doc/Data <input type="checkbox"/>   |             |             |   |   |                          |   |                        |                     |   |  |  |
| Equip/Tooling <input type="checkbox"/>  |             |             |   |   |                          |   |                        |                     |   |  |  |
| Operator <input type="checkbox"/>   |             |             |   |   |                          |   |                        |                     |   |  |  |
| Material <input type="checkbox"/>   |             |             |   |   |                          |   |                        |                     |   |  |  |
| Setup <input type="checkbox"/>  |             |             |   |   |                          |   |                        |                     |   |  |  |
| Other <input type="checkbox"/>  |             |             |   |   |                          |   |                        |                     |   |  |  |
| Process <input type="checkbox"/>  |             |             |   |   |                          |   |                        |                     |   |  |  |
| Supplier <input type="checkbox"/>   |             |             |   |   |                          |   |                        |                     |   |  |  |
| Training <input type="checkbox"/>   |             |             |   |   |                          |   |                        |                     |   |  |  |
| Unapproved <input type="checkbox"/>   |             |             |   |   |                          |   |                        |                     |   |  |  |
| <b>FAULT CATEGORY</b>   |             |             |   |   |                          |   |                        |                     |   |  |  |
| <b>Landing Gear</b><br><input type="checkbox"/> Bending<br><input type="checkbox"/> Centre Not Concentric to O/S<br><input type="checkbox"/> Cracks<br><input type="checkbox"/> Crushed/Crimped<br><input type="checkbox"/> Cuffs<br><input type="checkbox"/> Heat Treat<br><input type="checkbox"/> Inspection Strip in Tube<br><input type="checkbox"/> Ripples in Bend<br><input type="checkbox"/> Torque Waves in Extrusion<br><input type="checkbox"/> Turning Sequence<br><input type="checkbox"/> Wave/Twist in Tube |             |             | <b>General</b><br><input type="checkbox"/> Bend<br><input type="checkbox"/> BOM/Route<br><input type="checkbox"/> Broken/Damaged<br><input type="checkbox"/> Burrs<br><input type="checkbox"/> Contamination<br><input type="checkbox"/> Countersink<br><input type="checkbox"/> Cut Too Short<br><input type="checkbox"/> Drill Holes<br><input type="checkbox"/> Drawing<br><input type="checkbox"/> Finish<br><input type="checkbox"/> Folio |   |                          | <input type="checkbox"/> Grain<br><input type="checkbox"/> Hardware<br><input type="checkbox"/> Inspection Incomplete<br><input type="checkbox"/> Instructions Incomplete/Unclear<br><input type="checkbox"/> Maintenance<br><input type="checkbox"/> Mislabeled<br><input type="checkbox"/> Misread<br><input type="checkbox"/> Offset<br><input type="checkbox"/> Out of Calibration<br><input type="checkbox"/> Out of Sequence<br><input type="checkbox"/> Outside Dimensions   |                        |                     | <input type="checkbox"/> Ovalized<br><input type="checkbox"/> Over/Under tolerance<br><input type="checkbox"/> Part Incorrect<br><input type="checkbox"/> Part Lost/Missing<br><input type="checkbox"/> Part Moved<br><input type="checkbox"/> Positioned Wrong<br><input type="checkbox"/> Power Loss/Surge<br><br><input type="checkbox"/> Pressure/Forced<br><input type="checkbox"/> Temperature/Cure<br><input type="checkbox"/> Weld<br><input type="checkbox"/> Wrong Stock Pulled<br><br><input type="checkbox"/> Other |  |  |

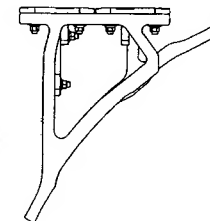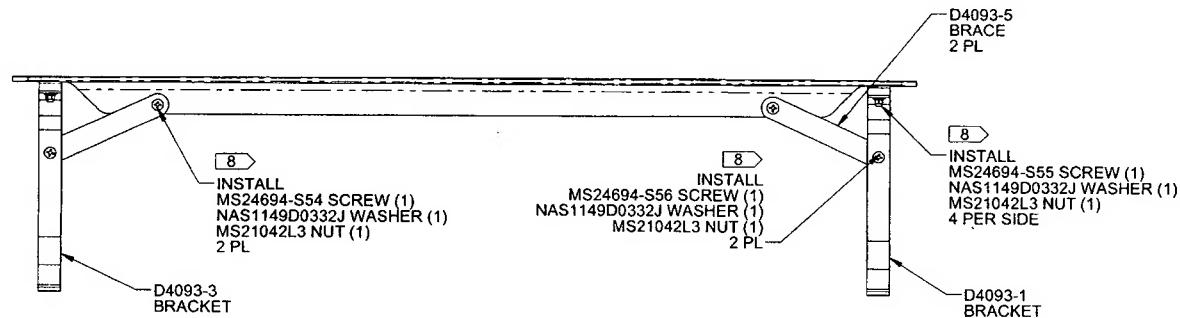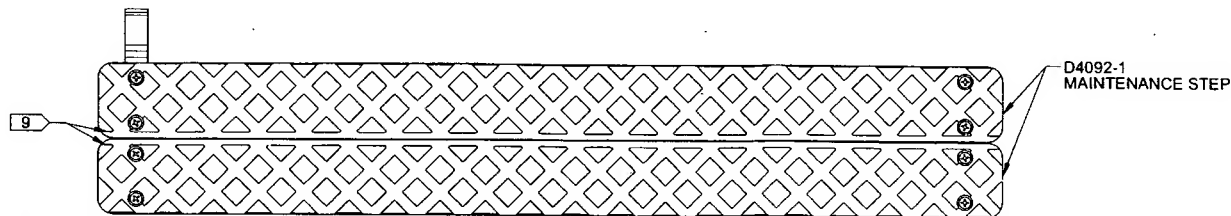

# **D4092-041 MAINTENANCE STEP ASSEMBLY**

## **NOTES:**

- 1) MATERIAL: N/A
- 2) FINISH: N/A
- 3) TOLERANCES: PER DART QSI 018 UNLESS OTHERWISE NOTED
- 4) UNITS: INCHES UNLESS OTHERWISE NOTED
- 5) BREAK SHARP EDGES: 0.005 TO 0.010 MAX
- 6) IDENTIFICATION: PER QSI 044 6.1
- 7) WEIGHT: 5.37 lbs
- 8) TORQUE SCREWS UP TO 15-25 in-lb (1.7-2.8 N-m)
- 9) GRIP CUTOUT TOWARD CENTER

|            |          |   |              |
|------------|----------|---|--------------|
| DESIGN     | RF       | <b>DART AEROSPACE USA, INC.</b>   |              |
| DRAWN      | RF       | KENT, WA  |              |
| CHECKED    | RF       | DRAWING NO.   | REV. B       |
| MFG. APPR. | RF       | <b>D4092</b>  | SHEET 3 OF 6 |
| APPROVED   | RF       | TITLE   | SCALE        |
| DE APPR.   | RF       | <b>MAINTENANCE STEP ASS'Y</b>   | NTS          |
| DATE       | 11.07.27 | <small>COPYRIGHT © 2010 BY DART AEROSPACE USA, INC.<br/>THIS DOCUMENT IS PRIVATE AND CONFIDENTIAL AND IS SUPPLIED ON THE EXPRESS CONDITION THAT IT IS<br/>NOT TO BE USED FOR ANY PURPOSE OR COPIED OR COMMUNICATED TO ANY OTHER PERSON WITHOUT<br/>WRITTEN PERMISSION FROM DART AEROSPACE USA, INC.</small> |              |

**RELEASED**  
2011-09-22

NCR: Yes / No

**WORK ORDER NON-CONFORMANCE / UPDATE**

DQA: \_\_\_\_\_ Date: \_\_\_\_\_

QA Closed: \_\_\_\_\_ Date: \_\_\_\_\_

|  |   |   |                                      |                                    |                                    |                                      |                                    |                                    |  |                                  |  |                                    |  |                                |                                    |                                    |                                   |  |
|--|---|---|--------------------------------------|------------------------------------|------------------------------------|--------------------------------------|------------------------------------|------------------------------------|--|----------------------------------|--|------------------------------------|--|--------------------------------|------------------------------------|------------------------------------|-----------------------------------|--|
| Work Order: _____<br><br>Part No. _____<br><br>NCR No. _____ | <b>DISPOSITION</b><br><br>Rework <input type="checkbox"/><br>Scrap <input type="checkbox"/><br>Use-as-is <input type="checkbox"/><br>Work Order Update <input type="checkbox"/> | <b>AGAINST DEPARTMENT/PROCESS</b><br><br><table style="width: 100%;"> <tr> <td>Skid-tube <input type="checkbox"/></td> <td>Crosstube <input type="checkbox"/></td> <td>Water Jet <input type="checkbox"/></td> <td>Engineering <input type="checkbox"/></td> </tr> <tr> <td>Machining <input type="checkbox"/></td> <td>Small Fab <input type="checkbox"/></td> <td>Prod. Eng. Coord. <input type="checkbox"/></td> <td>Quality <input type="checkbox"/></td> </tr> <tr> <td>Thermoforming <input type="checkbox"/></td> <td>Finishing <input type="checkbox"/></td> <td>Rec/Store/Packaging <input type="checkbox"/></td> <td>Other <input type="checkbox"/></td> </tr> <tr> <td>Large Fab <input type="checkbox"/></td> <td>Composite <input type="checkbox"/></td> <td>Supplier <input type="checkbox"/></td> <td></td> </tr> </table> | Skid-tube <input type="checkbox"/>   | Crosstube <input type="checkbox"/> | Water Jet <input type="checkbox"/> | Engineering <input type="checkbox"/> | Machining <input type="checkbox"/> | Small Fab <input type="checkbox"/> | Prod. Eng. Coord. <input type="checkbox"/> | Quality <input type="checkbox"/> | Thermoforming <input type="checkbox"/> | Finishing <input type="checkbox"/> | Rec/Store/Packaging <input type="checkbox"/> | Other <input type="checkbox"/> | Large Fab <input type="checkbox"/> | Composite <input type="checkbox"/> | Supplier <input type="checkbox"/> |  |
| Skid-tube <input type="checkbox"/>                           | Crosstube <input type="checkbox"/>  | Water Jet <input type="checkbox"/>  | Engineering <input type="checkbox"/> |                                    |                                    |                                      |                                    |                                    |  |                                  |  |                                    |  |                                |                                    |                                    |                                   |  |
| Machining <input type="checkbox"/>                           | Small Fab <input type="checkbox"/>  | Prod. Eng. Coord. <input type="checkbox"/>  | Quality <input type="checkbox"/>     |                                    |                                    |                                      |                                    |                                    |  |                                  |  |                                    |  |                                |                                    |                                    |                                   |  |
| Thermoforming <input type="checkbox"/>                       | Finishing <input type="checkbox"/>  | Rec/Store/Packaging <input type="checkbox"/>  | Other <input type="checkbox"/>       |                                    |                                    |                                      |                                    |                                    |  |                                  |  |                                    |  |                                |                                    |                                    |                                   |  |
| Large Fab <input type="checkbox"/>                           | Composite <input type="checkbox"/>  | Supplier <input type="checkbox"/>   |                                      |                                    |                                    |                                      |                                    |                                    |  |                                  |  |                                    |  |                                |                                    |                                    |                                   |  |

| Root Cause    | Date | Step | Qty | Description of work order update or Non-conformance | Initial Chief Eng | Action Description | Sign & Date | Verification | QC Inspector |
|---------------|------|------|-----|---|-------------------|--------------------|-------------|--------------|--------------|
| Doc/Data      |      |      |     |   |                   |                    |             |              |              |
| Equip/Tooling |      |      |     |   |                   |                    |             |              |              |
| Operator      |      |      |     |   |                   |                    |             |              |              |
| Material      |      |      |     |   |                   |                    |             |              |              |
| Setup         |      |      |     |   |                   |                    |             |              |              |
| Other         |      |      |     |   |                   |                    |             |              |              |
| Process       |      |      |     |   |                   |                    |             |              |              |
| Supplier      |      |      |     |   |                   |                    |             |              |              |
| Training      |      |      |     |   |                   |                    |             |              |              |
| Unapproved    |      |      |     |   |                   |                    |             |              |              |

**FAULT CATEGORY**

| Landing Gear  | General                                 | Other  |
|---|---|--|
| <input type="checkbox"/> Bending                      | <input type="checkbox"/> Bend           | <input type="checkbox"/> Grain                           |
| <input type="checkbox"/> Centre Not Concentric to O/S | <input type="checkbox"/> BOM/Route      | <input type="checkbox"/> Hardware                        |
| <input type="checkbox"/> Cracks                       | <input type="checkbox"/> Broken/Damaged | <input type="checkbox"/> Inspection Incomplete           |
| <input type="checkbox"/> Crushed/Crimped              | <input type="checkbox"/> Burrs          | <input type="checkbox"/> Instructions Incomplete/Unclear |
| <input type="checkbox"/> Cuffs                        | <input type="checkbox"/> Contamination  | <input type="checkbox"/> Maintenance                     |
| <input type="checkbox"/> Heat Treat                   | <input type="checkbox"/> Countersink    | <input type="checkbox"/> Misabeled                       |
| <input type="checkbox"/> Inspection Strip in Tube     | <input type="checkbox"/> Cut Too Short  | <input type="checkbox"/> Misread                         |
| <input type="checkbox"/> Ripples in Bend              | <input type="checkbox"/> Drill Holes    | <input type="checkbox"/> Offset                          |
| <input type="checkbox"/> Torque Waves in Extrusion    | <input type="checkbox"/> Drawing        | <input type="checkbox"/> Out of Calibration              |
| <input type="checkbox"/> Turning Sequence             | <input type="checkbox"/> Finish         | <input type="checkbox"/> Out of Sequence                 |
| <input type="checkbox"/> Wave/Twist in Tube           | <input type="checkbox"/> Folio          | <input type="checkbox"/> Outside Dimensions              |
|   |   | <input type="checkbox"/> Ovalized                        |
|   |   | <input type="checkbox"/> Over/Under tolerance            |
|   |   | <input type="checkbox"/> Part Incorrect                  |
|   |   | <input type="checkbox"/> Part Lost/Missing               |
|   |   | <input type="checkbox"/> Part Moved                      |
|   |   | <input type="checkbox"/> Positioned Wrong                |
|   |   | <input type="checkbox"/> Power Loss/Surge                |
|   |   | <input type="checkbox"/> Pressure/Forced                 |
|   |   | <input type="checkbox"/> Temperature/Cure                |
|   |   | <input type="checkbox"/> Weld                            |
|   |   | <input type="checkbox"/> Wrong Stock Pulled              |
|   |   | <input type="checkbox"/> Other                           |

DART AEROSPACE USA, INC.

IIN-D139-799

Page 43 of 45

## 5.0 PARTS LIST

| Qty<br>-011  | Qty<br>-012  | Qty<br>-015 | Qty<br>-017 | Qty<br>-019 | Qty<br>-112  | Part Number        | Description                            |
|--------------|--------------|-------------|-------------|-------------|--------------|--------------------|--|
| X            |              |             |             |             |              | D139-799-011       | MAINTENANCE STEP KIT, LH               |
|              | X            |             |             |             |              | D139-799-012       | MAINTENANCE STEP KIT, RH               |
|              |              | X           |             |             |              | D139-799-015       | ENGINE WASH KIT                        |
|              |              |             | X           |             |              | D139-799-017       | CARGO FLOOR PROTECTOR KIT              |
|              |              |             |             | X           |              | D139-799-019       | CABIN FLOOR PROTECTOR KIT              |
|              |              |             |             |             | X            | D139-799-112       | MAINTENANCE STEP WITH GRAB BAR KIT, RH |
|              |              |             | 2           |             |              | D3580-1            | JOGGLE BRACKET                         |
|              |              |             | 2           | 8           |              | D3628-1            | CUPPED WASHER                          |
| 1            |              |             |             |             |              | D4092-041          | MAINTENANCE STEP ASSEMBLY              |
|              | 1            |             |             |             |              | D4092-042          | MAINTENANCE STEP ASSEMBLY              |
|              |              | 2           |             |             |              | D4121-1            | HOSE ASSEMBLY                          |
|              |              | 1           |             |             |              | D4121-3            | HOSE ASSEMBLY                          |
|              |              | 1           |             |             |              | D4121-5            | HOSE ASSEMBLY                          |
|              |              |             |             | 1           |              | D4130-1            | FWD CABIN FLOOR PROTECTOR              |
|              |              |             |             | 1           |              | D4130-3            | AFT CABIN FLOOR PROTECTOR              |
|              |              |             | 1           |             |              | D4130-5            | FWD CARGO FLOOR PROTECTOR              |
|              |              |             | 1           |             |              | D4130-7            | CENTER CARGO FLOOR PROTECTOR           |
|              |              |             | 1           |             |              | D4130-9            | AFT CARGO FLOOR PROTECTOR              |
|              |              | 1           |             |             |              | D4131-041          | MANIFOLD ASSEMBLY                      |
|              |              | 1           |             |             |              | D4131-043          | DOUBLER ASSEMBLY                       |
|              |              | 2           |             |             |              | D4146-1            | FITTING                                |
|              |              |             | 1           |             |              | D4153-1            | JOGGLE BRACKET                         |
|              |              |             | 1           |             |              | D4153-3            | JOGGLE BRACKET                         |
|              |              |             |             | 4           |              | D4153-5            | CLAMP PLATE                            |
|              |              |             | 2           |             |              | D4166-1            | PLACARD, MAX LOAD                      |
|              |              | 2           |             |             |              | D4182-1            | FITTING, QUICK DISCONNECT              |
|              |              | 1           |             |             |              | D4384-1            | PLACARD                                |
|              |              |             |             |             | 1            | D4526-042          | MAINTENANCE STEP ASSEMBLY, RH          |
| <del>2</del> | <del>2</del> |             |             |             | <del>2</del> | <del>AN6H12A</del> | <del>BOLT</del>                        |
| <del>2</del> | <del>2</del> |             |             |             | <del>2</del> | <del>AN6H13A</del> | <del>BOLT</del>                        |
|              |              | 4           |             |             |              | AN526-1032R16      | SCREW                                  |
|              |              | 2           |             |             |              | AN832-6J           | UNION                                  |
|              |              | 4           |             |             |              | AN924-6J           | NUT                                    |
|              |              | 20          |             |             |              | MS21919WDG09       | CLAMP                                  |
| 6            | 6            |             |             |             | 6            | NAS1149D0663J      | WASHER (or AN960JD616)                 |
|              |              | 2           |             |             |              | NAS1149C0932R      | WASHER (or AN960C916L)                 |

• COPYRIGHT © 2010 BY DART AEROSPACE USA, INC. •

THIS DOCUMENT IS PRIVATE AND CONFIDENTIAL AND IS SUPPLIED ON THE EXPRESS CONDITION THAT IT IS NOT TO BE USED FOR ANY PURPOSE OR COPIED OR COMMUNICATED TO ANY OTHER PERSON WITHOUT WRITTEN PERMISSION FROM DART AEROSPACE USA, INC.

Revision: G

Date: 12.09.18